

THE NORTH YORKSHIRE COUNCIL (20 MPH AND 30 MPH SPEED LIMITS)
(VARIOUS ROADS, ROECLIFFE) ORDER 2026

The North Yorkshire Council in exercise of their powers under Sections 84(1) and (2) of the Road Traffic Regulation Act 1984 ("the 1984 Act") and Part IV of Schedule 9 to the 1984 Act and of all other enabling powers, after consultation with the Chief Officer of Police in accordance with Part III of Schedule 9 to the 1984 Act, hereby order as follows:-

1. No person shall drive any motor vehicle at a speed exceeding 20 miles per hour on any length of road specified in Schedule 1 hereto.
2. No person shall drive any motor vehicle at a speed exceeding 30 miles per hour on any length of road specified in Schedule 2 hereto.
3. The prohibitions and restrictions imposed by this Order shall be in addition to and not in derogation from any restriction or requirement imposed by any Order or regulations made or having effect as if made under the Act or by or under any other enactment.
4. This Order shall come into operation on 23 February 2026 and may be cited as: The North Yorkshire Council (20 mph and 30 mph Speed Limits) (Various Roads, Roecliffe) Order 2026
5. Traffic Regulation Order "North Yorkshire County Council (Restricted Road) (C263, Roecliffe) Order 1996" is revoked in so far as it relates to Schedule 1: C263, Bar Lane: From a point 20 metres north east of its junction with Sheaflands Lane in a generally easterly direction for a distance of 1700 metres.

SCHEDULE 1

ROAD(S) IN THE VILLAGE/PARISH OF ROECLIFFE

20 MPH SPEED LIMIT

<u>Column 1</u> <u>Item</u>	<u>Column 2</u> <u>Road</u>	<u>Column 3</u> <u>Side</u>	<u>Column 4</u> <u>Length</u>
1	Bar Lane C263/2/70 Roecliffe	Both	From a point 10m south east of the boundary line of property number 1 of Orchard Cottages for a distance of 426.5m in a north westerly direction
2	Unnamed Road (U3622/1/50) Roecliffe	Both	In its entirety

SCHEDULE 2

ROAD(S) IN THE VILLAGE/PARISH OF ROECLIFFE

30 MPH SPEED LIMIT

<u>Column 1 Item</u>	<u>Column 2 Road</u>	<u>Column 3 Side</u>	<u>Column 4 Length</u>
1	Bar Lane C263/2/70 Roecliffe	Both	From a point 20m north east of it's junction with Sheaflands Lane in a generally easterly direction for a distance of 164.7m
2	Bar Lane C263/2/70 Roecliffe	Both	From a point 10m south east of the boundary line of property number 1 of Orchard cottages for a distance of 1108.8m in a south easterly direction

SCHEDULE 3

ROAD(S) IN THE VILLAGE/PARISH OF ROECLIFFE

REVOCATIONS


<u>Column 1 Title of Order</u>	<u>Column 2 Extent of Revocation</u>
North Yorkshire County Council (Restricted Road) (C263, Roecliffe) Order 1996	In so far as it relates to Schedule 1 <ul style="list-style-type: none">C263, Bar Lane: From a point 20 metres north east of its junction with Sheaflands Lane in a generally easterly direction for a distance of 1700 metres.

THE COMMON SEAL of THE NORTH YORKSHIRE COUNCIL was hereunto affixed this 13th day of February 2026 in the presence of:-



**AUTHORISED
SIGNATORY**



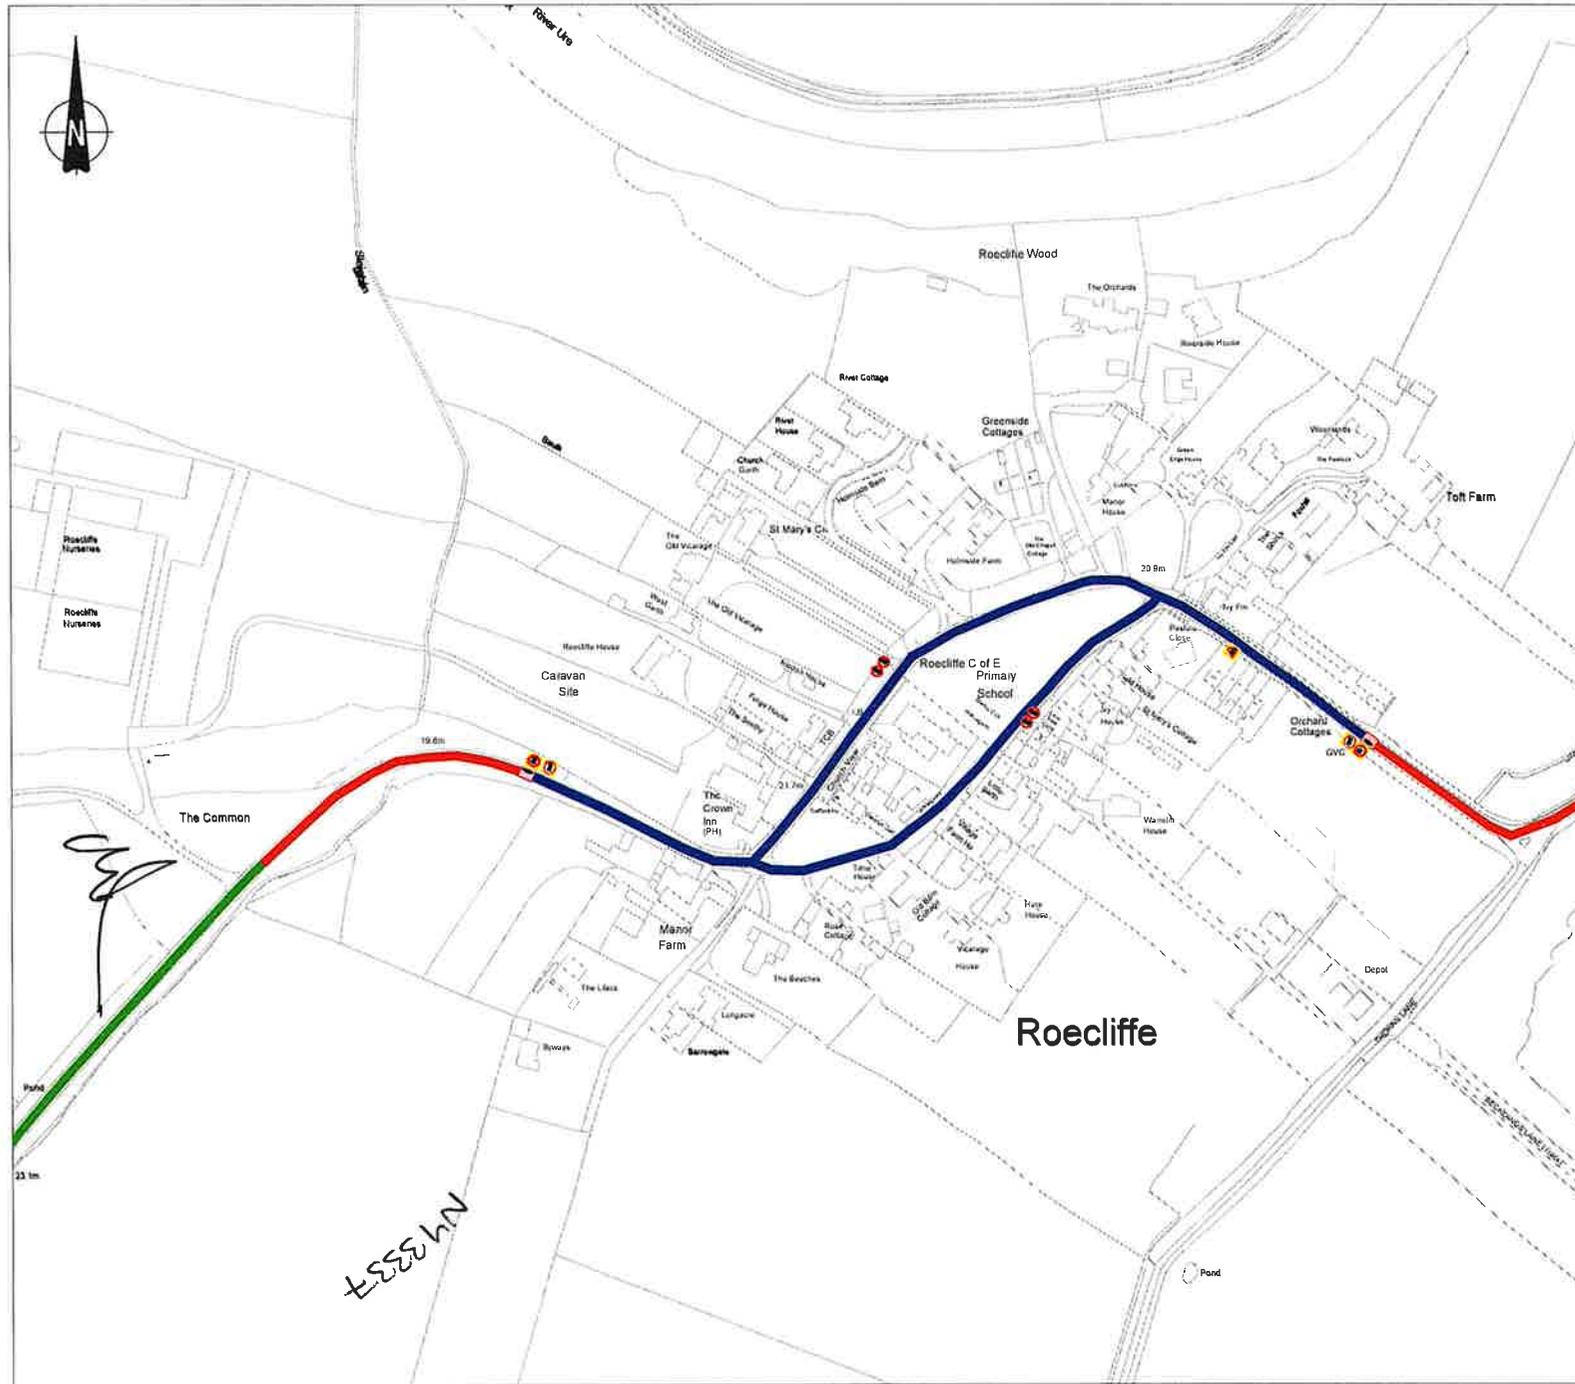

Key:

- 30mph Speed Limit
- 20mph Speed Limit
- National Speed Limit
- 20mph/30mph Speed Limit Terminal Point
- 20mph Repeater Plates (Dia.670 - 300mm diameter)

THIS MAP IS REPRODUCED FROM ORDNANCE SURVEY MATERIAL WITH THE PERMISSION OF ORDNANCE SURVEY ON BEHALF OF THE CONTROLLER OF HER MAJESTY'S STATIONERY OFFICE © CROWN COPYRIGHT. UNAUTHORISED REPRODUCTION INFRINGES CROWN COPYRIGHT AND MAY LEAD TO PROSECUTION OR CIVIL PROCEEDINGS. NORTH YORKSHIRE COUNCIL 100017945.

3	Bar Lane 20mph TRO	ZS	CB	CB
Ver.	Details	Author & Date	Checked & Date	Approved & Date



Racecourse Lane, Northallerton, North Yorkshire, DL7 8AD
Tel: 0300 131 2131

Directorate
HIGHWAYS & TRANSPORTATION

Project Name
Area 6 Boroughbridge
Speed Limit TRO

Drawing Title
Bar Lane
Rocliffe

Purpose
20mph TRO

Scale	Drawn	Checked	Approved
NTS	ZS	CB	CB
Original Size	Date	Date	Date
A3	6/2/26	6/2/26	6/2/26

Drawing Number
NYC-DR-A6-ROELIFFE_20MPH-FINAL (As Built)

Version